

**SCDHEC OFFICE OF OCEAN AND COASTAL RESOURCE MANAGEMENT
PERMIT APPLICATION PUBLIC NOTICE**

October 30, 2009

Permit Number: OCRM-09-927-G
Permit ID: 68301

The SCDHEC Office of Ocean and Coastal Resource Management has received an application for a permit for the alteration of a critical area. This application was submitted pursuant to the Coastal Zone Management Act (Act 123) of the 1977 South Carolina General Assembly. The application, in brief, is described as follows:

APPLICANT: Guy Paschal
C/o Atlantic Marine Construction Co., Inc.
372 County Shed Road
Beaufort, SC 29906

LOCATION: On and adjacent to Broomfield Creek at 23 Cameroon Drive, Lady's Island, Beaufort County, South Carolina.
TMS#: R200-009-00C-0027-0000.

WORK: The work, as proposed and shown on the attached plans, consists of making an addition to an existing private dock. Specifically, the applicant proposes to place a 12'x13' four pile boatlift on the flood-side of an existing 10'x20' floating dock. The purpose of the dock addition is for the applicant's private, recreational use.

This public notice is being distributed to all known interested persons and agencies to assist in developing facts on which a decision by OCRM can be based. Comments concerning the proposed work should be submitted in writing, setting forth sufficient detail to furnish a clear understanding of the reasons for support or opposition.

The decision to issue or deny a permit will be based on the individual merits of the application, the policies specified in the South Carolina Coastal Zone Management Act, and the considerations outlined in the State of South Carolina Coastal Zone Management Program. Interested parties who wish to be notified of final permit action must notify OCRM in writing of this request.


To assure review by OCRM, comments regarding this application must be received by OCRM on or before November 14, 2009. For further information please contact the project manager for this activity, Geordie Madlinger at 843-846-9400.

PLEASE REPLY TO:

SCDHEC OFFICE OF OCEAN AND COASTAL RESOURCE MANAGEMENT
104 Parker Drive
Beaufort, South Carolina 29906

Please refer to P/N# OCRM-09-927-G


George J Madlinger, Senior Wetland Project Manager

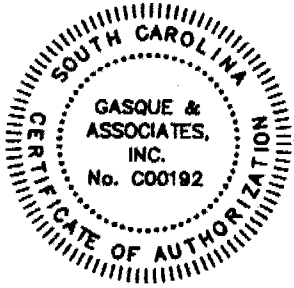


**GASQUE & ASSOCIATES INC.
LAND SURVEYORS & PLANNERS**

28 PROFESSIONAL VILLAGE CIRCLE, BEAUFORT, S.C.
P.O. BOX 1363, BEAUFORT, S.C.
PHONE (843) 522-1798


SHEET # 2 OF 3

PLAN VIEW

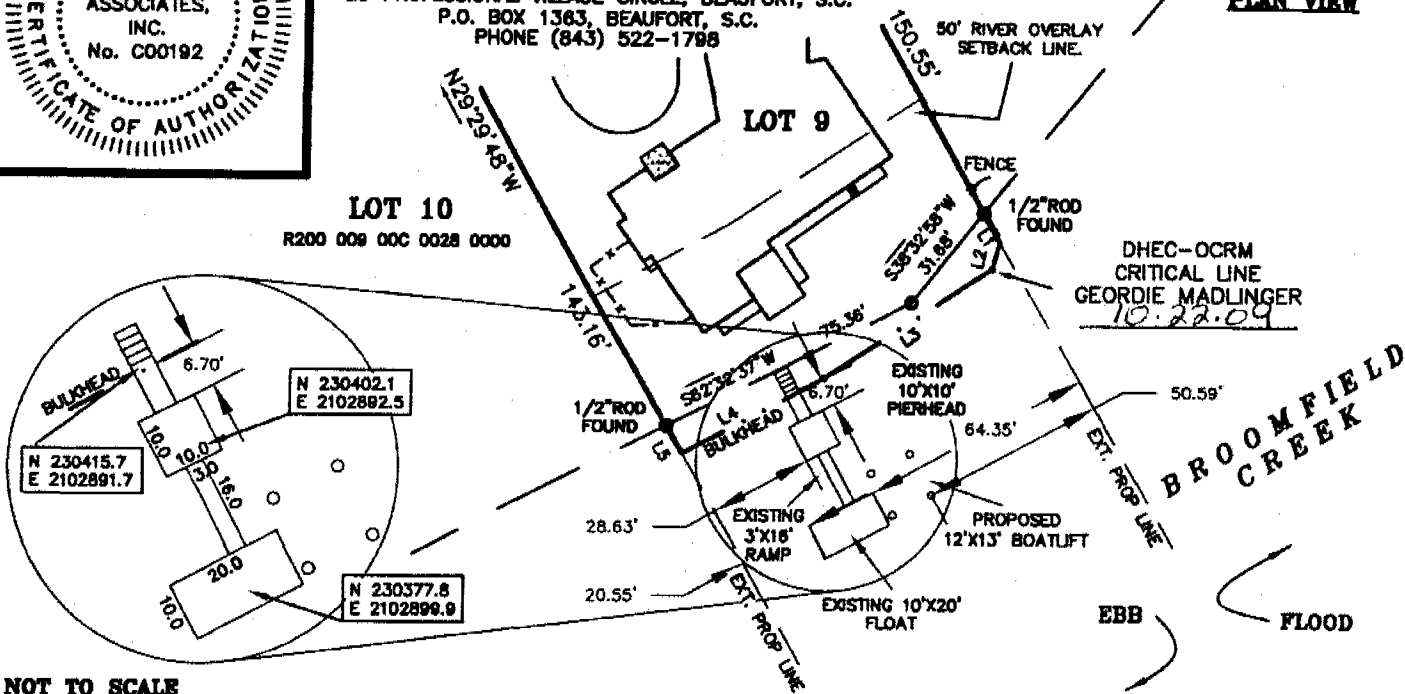

PROFILE VIEW

BROOMFIELD CREEK

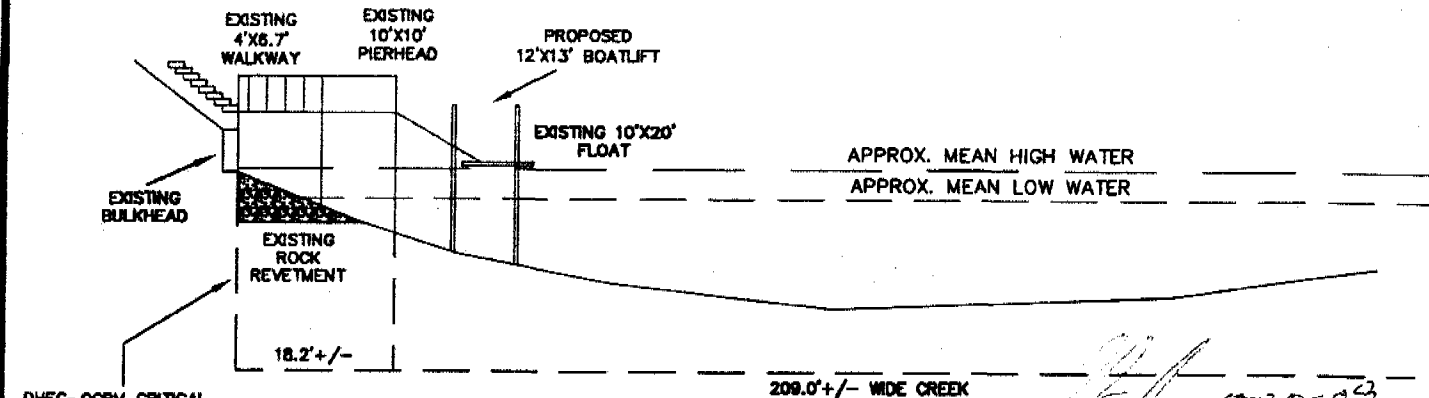

NOT TO SCALE

SURVEYOR SIGNED HEREON IS CHARGED WITH SURVEY MATTERS AND THE PHYSICAL DRAWING ON A COMPUTER DRAFTING SYSTEM ONLY. THIS IS NOT A DESIGN OR INTENDED TO BE ONE. ALL DEPICTIONS THAT ARE NOT SURVEY MATTERS IS PROVIDED BY OTHERS.

ADJACENT PROPERTY OWNERS:
1. JEFFERY & MARJORIE BEALS
25 CAMEROON DR
BEAUFORT, SC 29907
LOT 10, ISLAND B
R200 009 00C 0028 0000
2. PHILIP J. WAGNER
21 CAMEROON DR
BEAUFORT, SC 29907
LOT 8, ISLAND B
R200 009 00C 0026 0000

OCRM - 09-927-G

R200 009 00C 0027 0000
LOT 9, ISLAND B
SHAMMY CREEK LANDING
GUY PASCHAL
23 CAMEROON DR
BEAUFORT, SC 29907


DOCK ASBUILT FOR PERMIT

IN: SHAMMY CREEK LANDING SUB.

AT: BROOMFIELD CREEK

COUNTY OF: BEAUFORT
STATE: SOUTH CAROLINA

JOB# 36702 FB/JEP DSGN5 DATE: 10/19/09

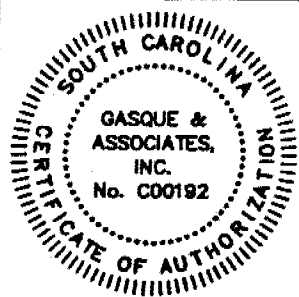


GASQUE & ASSOCIATES INC. **LAND SURVEYORS & PLANNERS**

28 PROFESSIONAL VILLAGE CIRCLE, BEAUFORT, S.C.
P.O. BOX 1363, BEAUFORT, S.C.
PHONE (843) 522-1798

SHEET # 1 OF 3

SURVEYOR SIGNED HEREON IS CHARGED WITH SURVEY MATTERS AND THE PHYSICAL DRAWING ON A COMPUTER DRAFTING SYSTEM ONLY. THIS IS NOT A DESIGN OR INTENDED TO BE ONE. ALL DEPICTIONS THAT ARE NOT SURVEY MATTERS IS PROVIDED BY OTHERS.

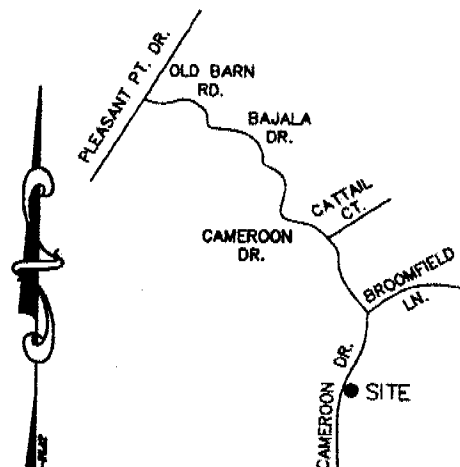


VICINITY MAP NOT TO SCALE

LOT 8


R200 009 00C 0026 0000

LINE	DIRECTION	DISTANCE
L1	S29°30'00"E	9.08'
L2	S15°48'22"W	7.58'
L3	S56°07'37"W	55.44'
L4	S81°19'22"W	44.03'
L5	N29°29'48"W	8.85'

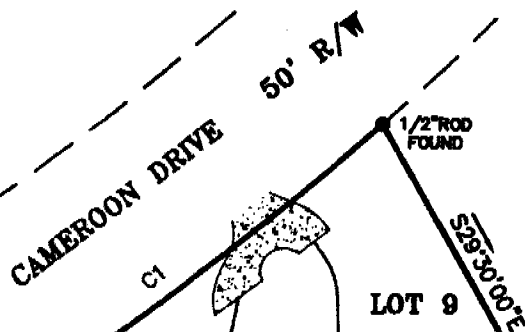

LOT 10

R200 009 00C 0026 0000

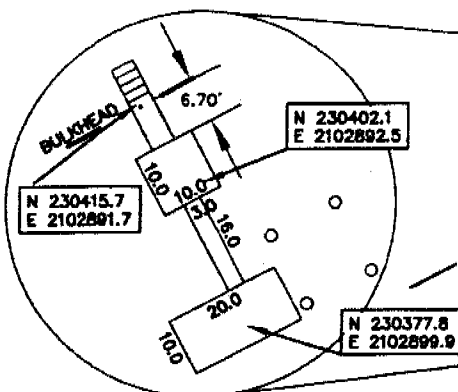

DHEC-OCRM
CRITICAL LINE
GEORDIE MADLINGER
10-22-09

BROOMFIELD CREEK

FLOOD

EBB

OCRM-09-927-G

CURVE	RADIUS	LENGTH	TANGENT	CHORD	BEARING	DELTA
C1	804.99'	106.07'	53.11'	105.99'	N51°31'13"E	07°32'58"

- ADJACENT PROPERTY OWNERS:**
- JEFFERY & MARJORIE BEALS
25 CAMEROON DR
BEAUFORT, SC 29907
LOT 10, ISLAND B
R200 009 00C 0026 0000
 - PHILIP J. WAGNER
21 CAMEROON DR
BEAUFORT, SC 29907
LOT 8, ISLAND B
R200 009 00C 0026 0000

0 25 50 100



SCALE: 1"=50'

R200 009 00C 0027 0000
LOT 9, ISLAND B
SHAMMY CREEK LANDING
GUY PASCHAL
23 CAMEROON DR
BEAUFORT, SC 29907


DOCK ASBUILT FOR PERMIT

IN: SHAMMY CREEK LANDING SUB.

AT: BROOMFIELD CREEK

COUNTY OF: BEAUFORT
STATE: SOUTH CAROLINA


JOB# 36702 FB/JEP DSGN5 DATE: 10/19/09

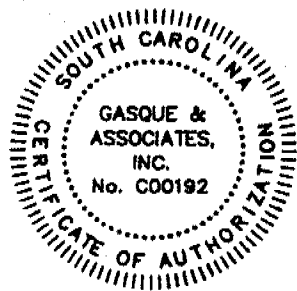


**GASQUE & ASSOCIATES INC.
LAND SURVEYORS & PLANNERS**

28 PROFESSIONAL VILLAGE CIRCLE, BEAUFORT, S.C.
P.O. BOX 1383, BEAUFORT, S.C.
PHONE (843) 522-1788

SHEET # 3 OF 3

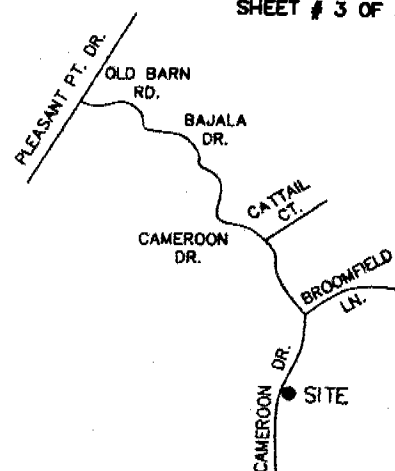

VICINITY MAP NOT TO SCALE

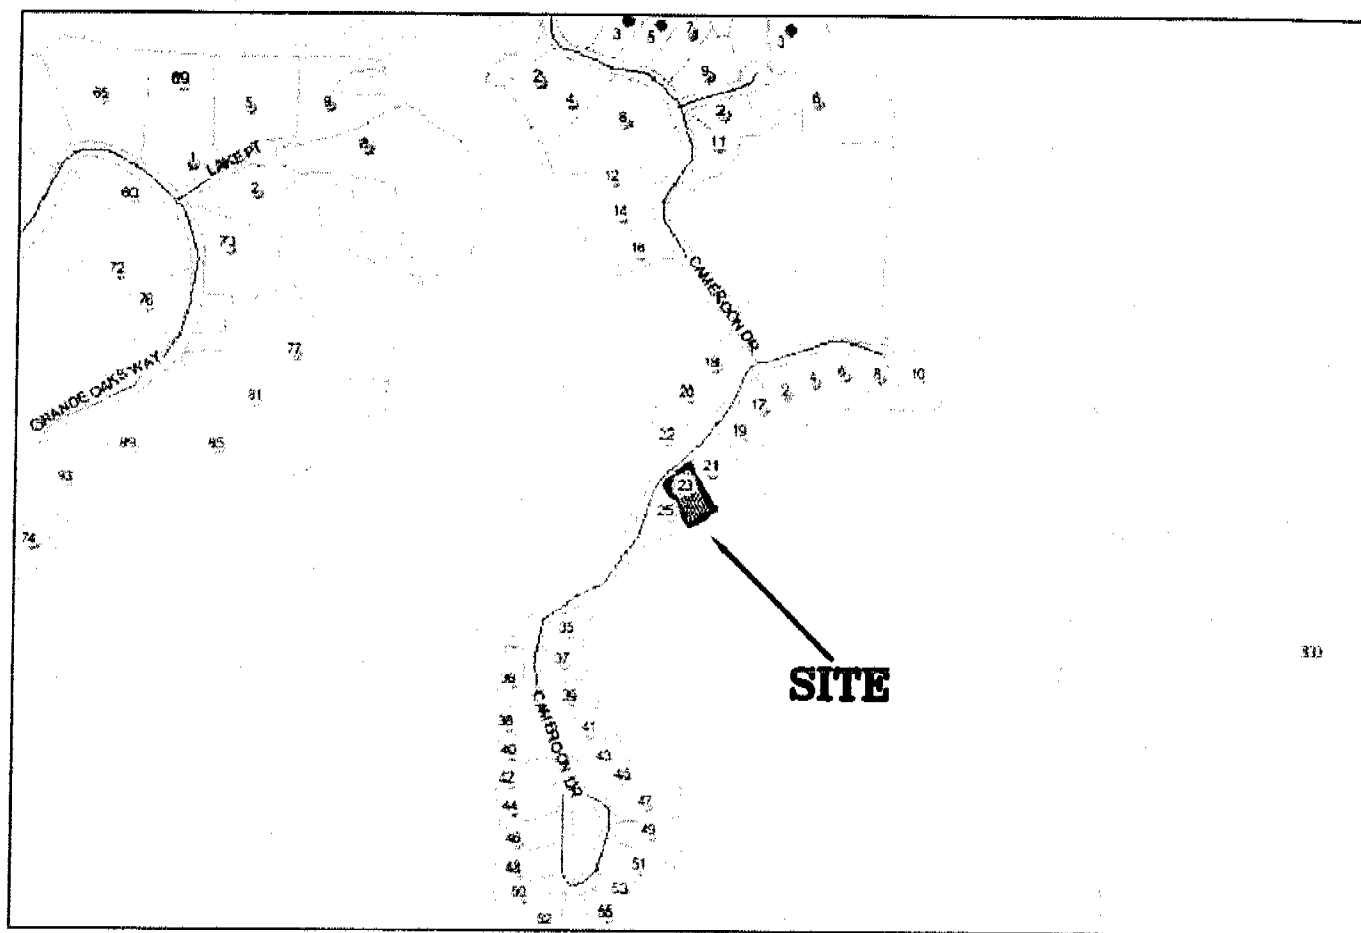

ADJACENT PROPERTY OWNERS:
1. JEFFERY & MARJORIE BEALS
25 CAMEROON DR
BEAUFORT, SC 29907
LOT 10, ISLAND B
R200 009 00C 0028 0000
2. PHILIP J. WAGNER
21 CAMEROON DR
BEAUFORT, SC 29907
LOT 8, ISLAND B
R200 009 00C 0028 0000

000m -09-927-G

R200 009 00C 0027 0000
LOT 9, ISLAND B
SHAMMY CREEK LANDING
GUY PASCHAL
23 CAMEROON DR
BEAUFORT, SC 29907

DOCK ASBUILT FOR PERMIT

IN: SHAMMY CREEK LANDING SUB.

AT: BROOMFIELD CREEK

COUNTY OF: BEAUFORT
STATE: SOUTH CAROLINA

JOB# 36702 FB/JEP DSGN5 DATE: 10/13/09